

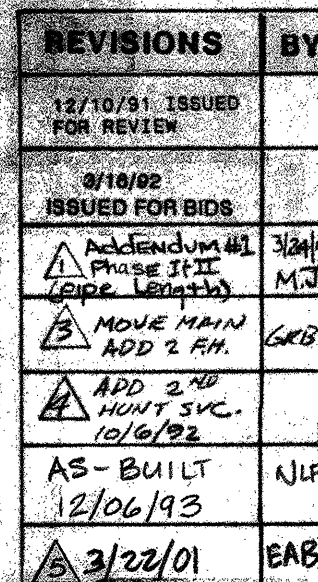


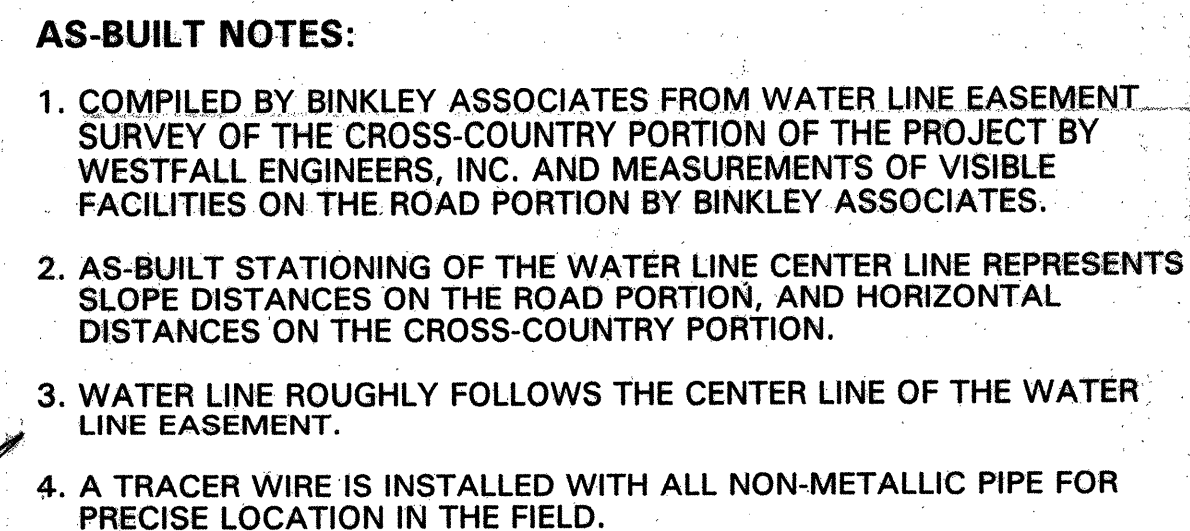

**WATER DISTRIBUTION
PLAN-PROFILE**
LINE "A" STA. 12+56 TO STA. 23+80
LINE "B" STA. 15+10 TO STA. 14+37

**BRUSH & OLD WELL MUTUAL WATER CO.
REMEDIAL WATER SYSTEM**

DATE:	11/05/91
SCALE:	AS SHOWN
DRAWN:	R.C.
JOB:	22002
SHEET:	3
OF	12 SHEETS

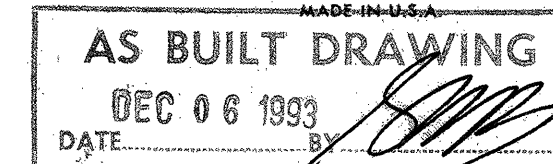

NO. 1263—PLAN PROFILE PLATE
"CLEARPRINT PAPER CO."

MADE IN U.S.A.
AS BUILT DRAWING
DEC 06 1993
DATE _____ BY *[Signature]*