


NOTE: LOCATE PIPE IN CUT SIDE OF ROADWAY UP HILL SIDE TO AVOID FILL & UNSTABLE AREAS.

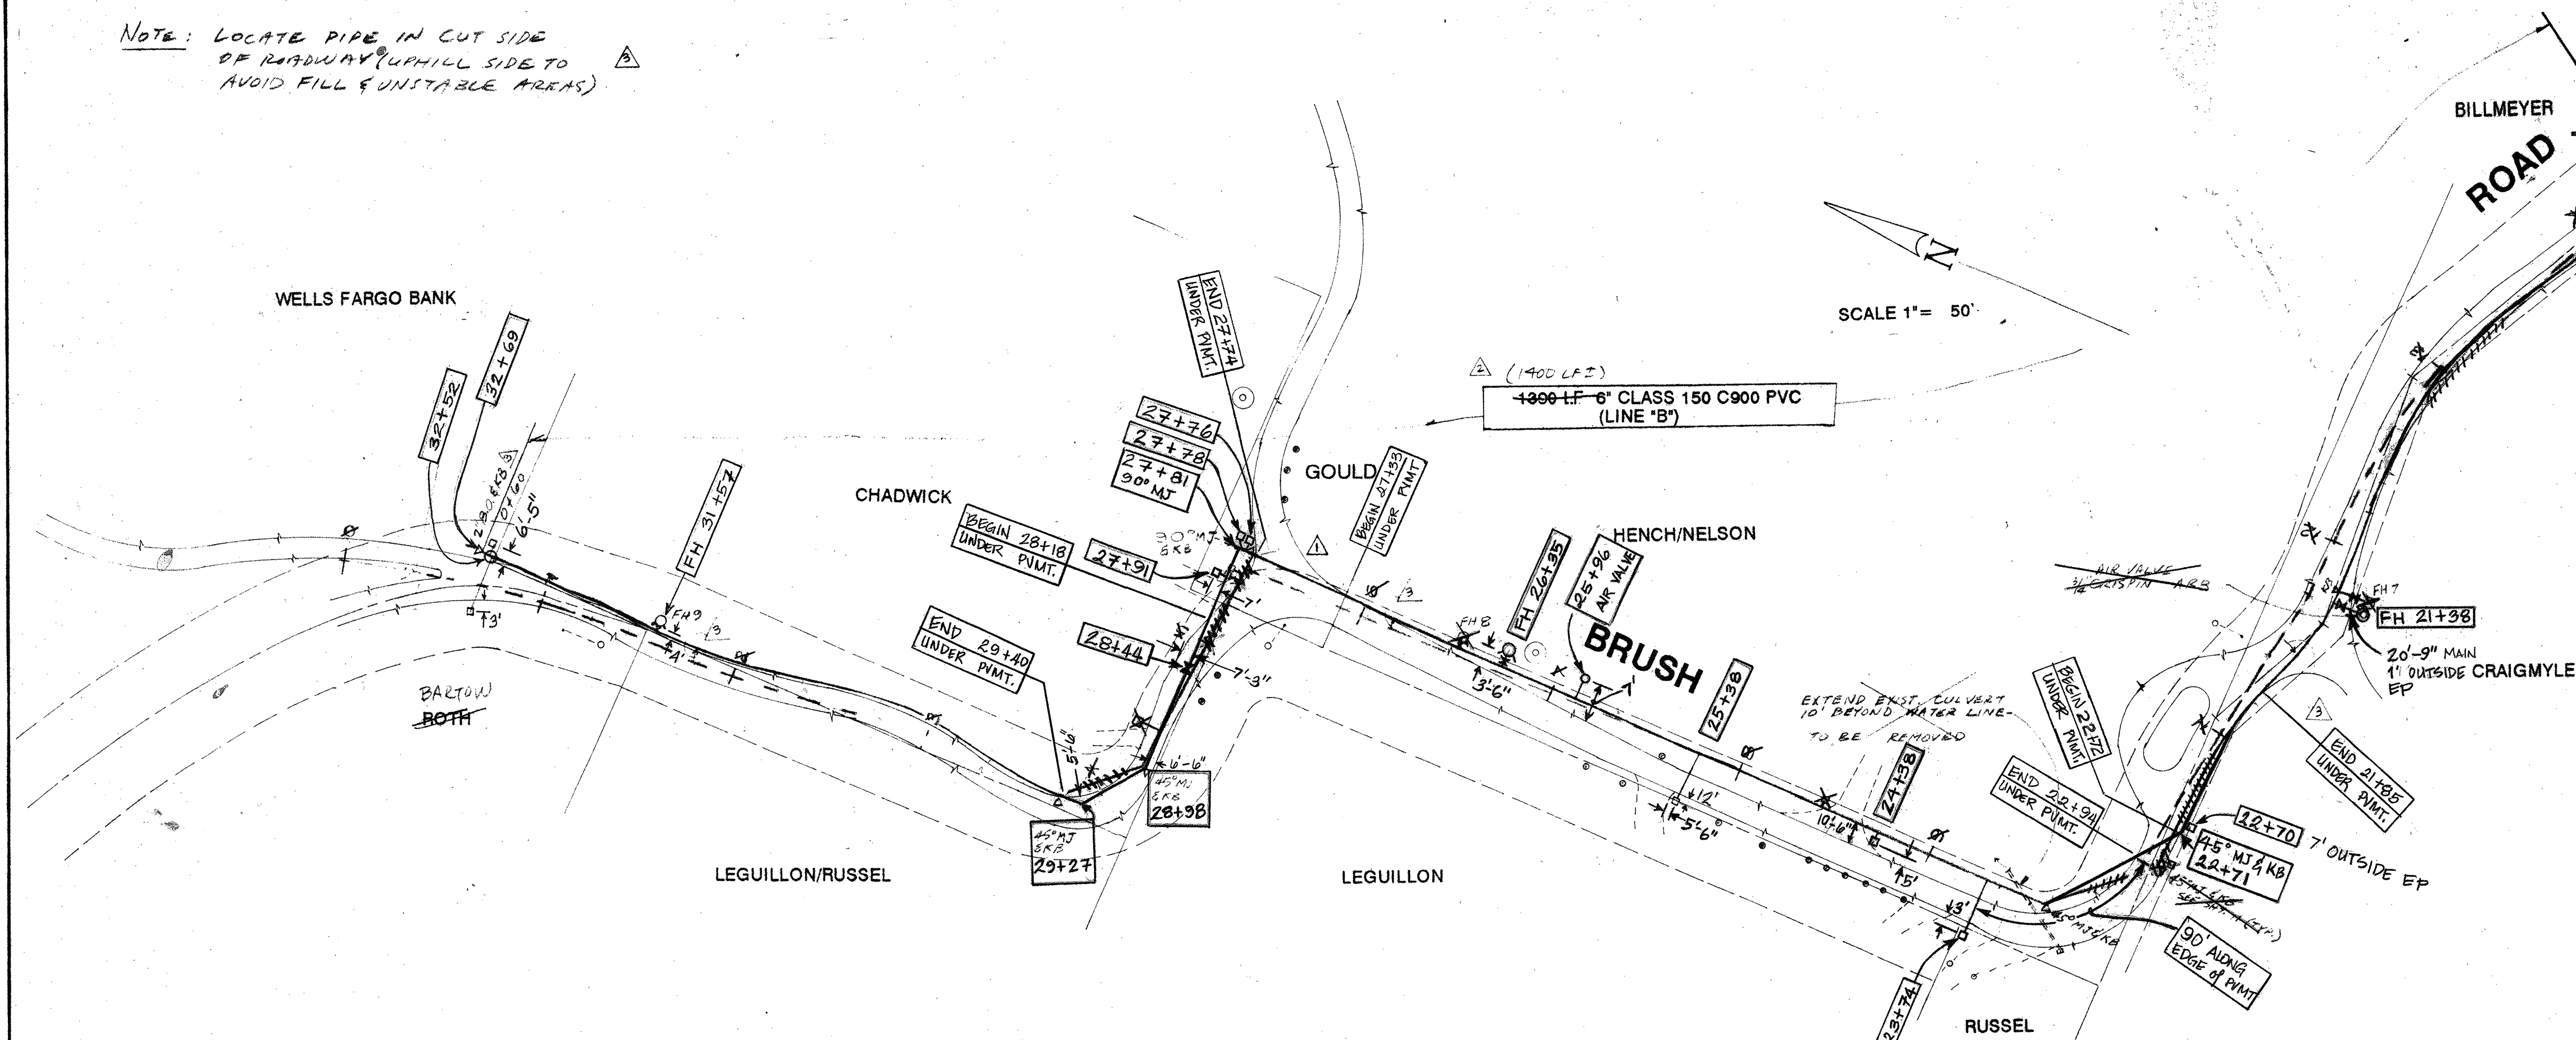


AS-BUILT NOTES:


1. COMPILED BY BINKLEY ASSOCIATES FROM WATER LINE EASEMENT SURVEY OF THE CROSS-COUNTRY PORTION OF THE PROJECT BY WESTFALL ENGINEERS, INC. AND MEASUREMENTS OF VISIBLE FACILITIES ON THE ROAD PORTION BY BINKLEY ASSOCIATES.
2. AS-BUILT STATIONING OF THE WATER LINE CENTER LINE REPRESENTS SLOPE DISTANCES ON THE ROAD PORTION, AND HORIZONTAL DISTANCES ON THE CROSS-COUNTRY PORTION.
3. WATER LINE ROUGHLY FOLLOWS THE CENTER LINE OF THE WATER LINE EASEMENT.
4. A TRACER WIRE IS INSTALLED WITH ALL NON-METALLIC PIPE FOR PRECISE LOCATION IN THE FIELD.

LEGEND

- FIRE HYDRANT (SEE SHEET 11) (FH)
- ⊗ GATE VALVE (GV)
- ⊗ BLOW OFF (B/O)
- SUPPLY SYSTEM PIPE & SIZE
- DISTRIBUTION SYSTEM PIPE & SIZE
- ⊗ PRESSURE REDUCING VALVE
- ⊗ DISTRIBUTION SYSTEM STORAGE TANK
- ⊗ AIR VALVE (AV)
- ⊗ WATER SERVICE (WS)
- STAGING AREA (AS STAKED IN FIELD)
- ⊗ EXISTING UTILITY POLE
- EXISTING TREE
- EXISTING CMP CULVERT (NOTE: SOME NEW CULVERTS NOT SHOWN) (SEE DETAIL SHEET 12)
- EP EDGE OF PAVEMENT

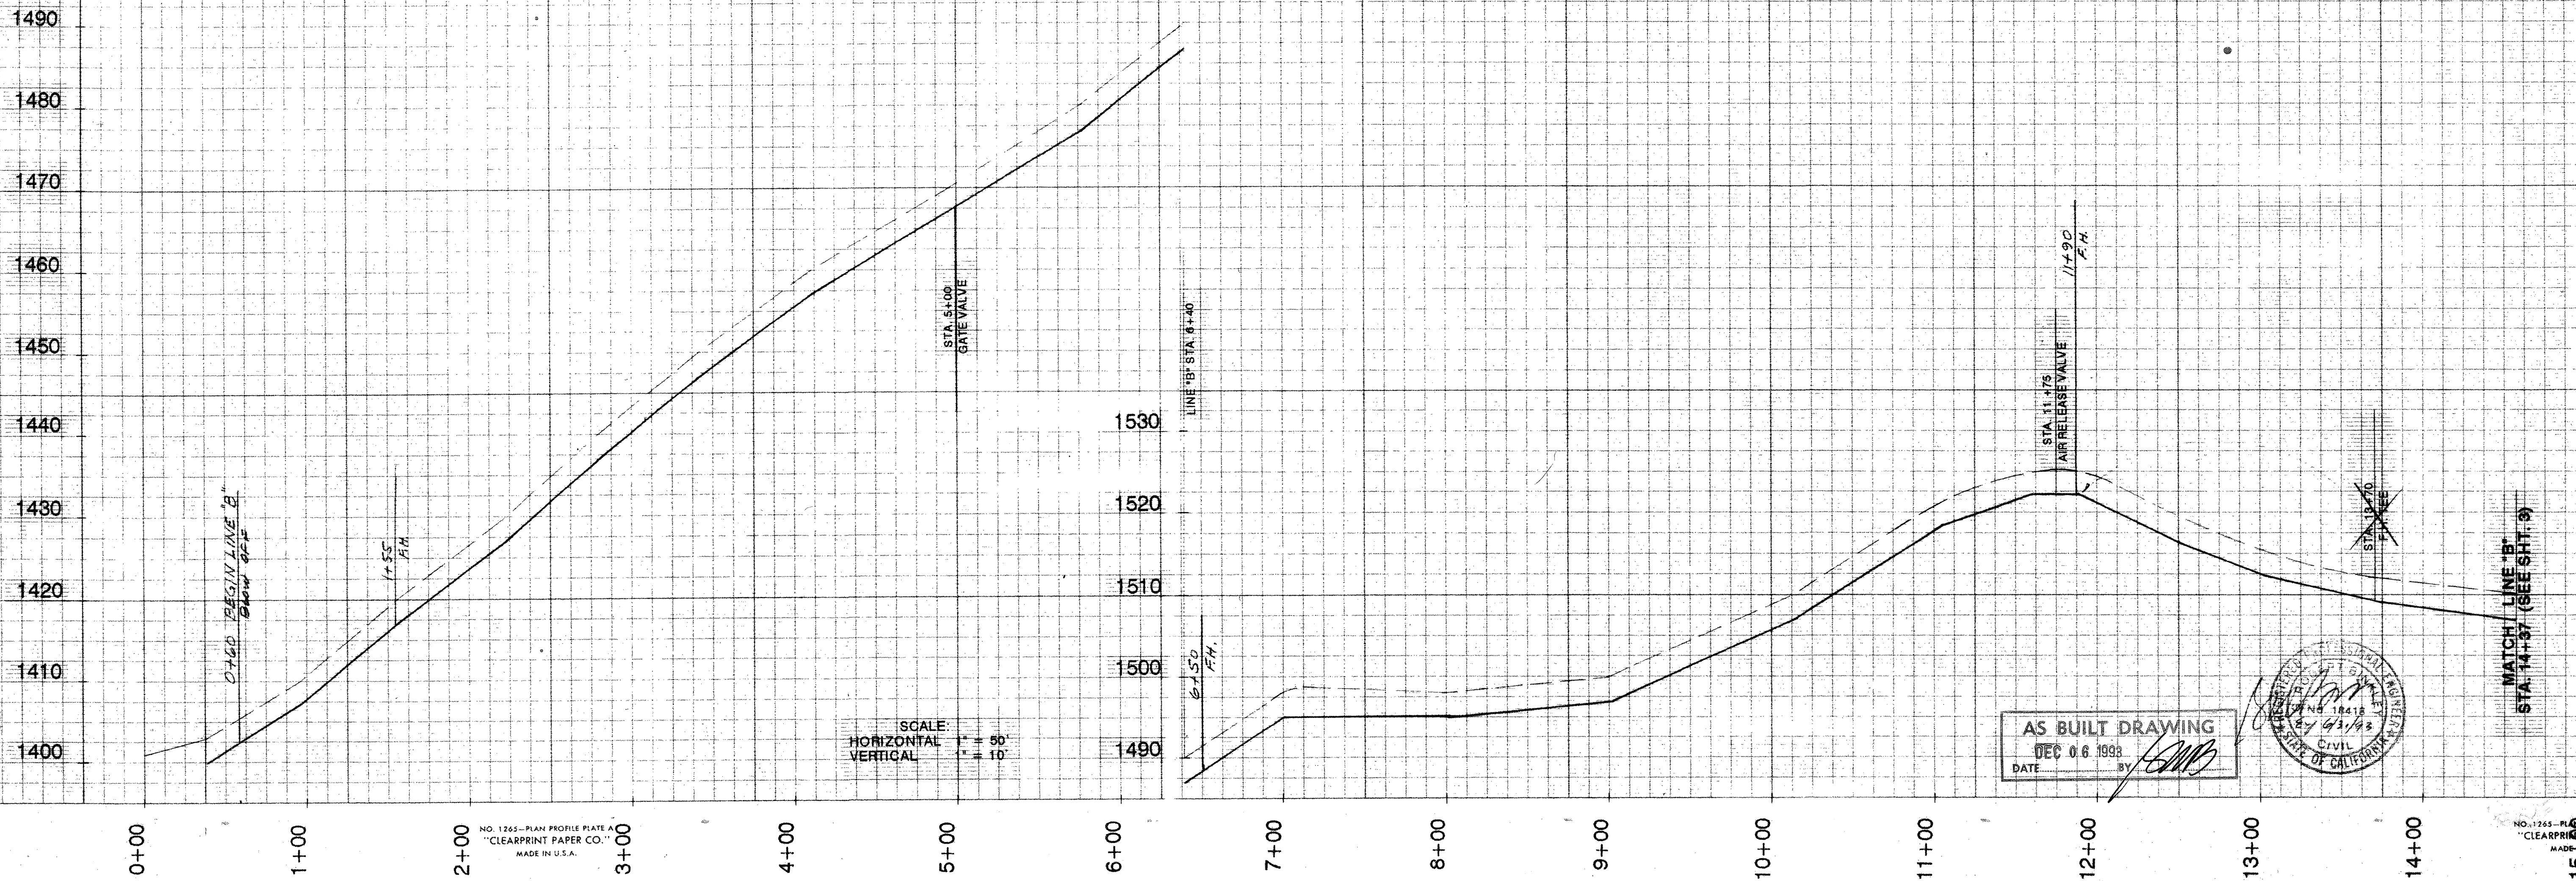

AS BUILT DRAWING
DEC 06 1993
DATE BY

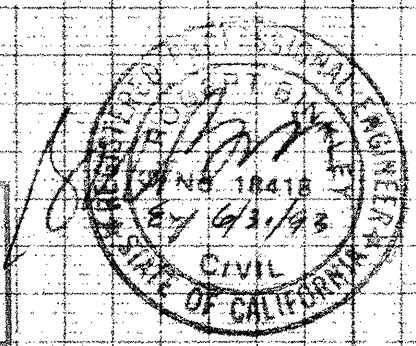

REVISIONS	BY
12/10/91 ISSUED FOR REVIEW	
3/18/92 ISSUED FOR BIDS	
ADD SERVICE (2/19/92)	MJS
ADDENDUM #2 PHASE 1 & 2 (2/19/92)	MJS
ADD 1" PVC (2/19/92)	MJS
ADD 1" PVC (2/19/92)	MJS
AS-BUILT 12/06/93	NLE

Binkley Associates
CONSULTING ENGINEERS
7246 SHARON DRIVE • SAN JOSE • CALIFORNIA 95129

WATER DISTRIBUTION
PLAN PROFILE
LINE 'B' STA. 00+46 TO STA. 14+37
PHASE I

BRUSH & OLD WELL MUTUAL WATER CO.
REMEDIAL WATER SYSTEM

DATE: 11/05/91
SCALE: AS SHOWN
DRAWN: R.C.
SHEET: 5
OF 12 SHEETS