

(SEE PIPELINE ALIGNMENT ON SHEET 2) CROSS-COUNTRY

DISTRIBUTION STORAGE TANK (PHASE I & III)

TANK SITE PIPING (SEE DTL. SHT. 10)

FLOAT/RELIEF TANK BYPASS STATION (PHASE II - SEE DTL. SHT. 12)

BEGIN LINE "C" (STA. 8+60)

CROSS-COUNTRY (SEE AS-BUILT NOTES & TABLE A - THIS SHEET)

800 L.F. 3" SDR 11 HDPE PIPE

SCALE: 1" = 50'

SEE TYPICAL TRENCH DETAIL (SHT. 12)

PRESSURE REGULATING/SUSTAINING STATION (SEE DTL. SHT. 12)

STAGING AREA

EXIST. DIRT ACCESS ROADS

MATCH LINE (SEE SHT. 7) STA. 25+00

TABLE A (CONT.)

PART 3 OF "EXHIBIT A - DESCRIPTION OF THE WATER PIPE LINE FOR BRUSH AND OLD WELL MUTUAL WATER COMPANY". (CENTER LINE OF WATER LINE EASEMENT)

thence North 55 Degrees 48 Minutes 00 Seconds West a distance of 57.30 feet;
thence North 46 Degrees 31 Minutes 15 Seconds West a distance of 77.10 feet;
thence North 34 Degrees 07 Minutes 15 Seconds West a distance of 55.27 feet;
thence North 46 Degrees 58 Minutes 00 Seconds West a distance of 65.03 feet;
thence North 38 Degrees 56 Minutes 20 Seconds West a distance of 61.60 feet;
thence South 13 Degrees 42 Minutes 55 Seconds West a distance of 29.15 feet;
thence South 00 Degrees 31 Minutes 50 Seconds West a distance of 105.30 feet;
thence South 15 Degrees 22 Minutes 10 Seconds East a distance of 62.45 feet;
thence South 03 Degrees 28 Minutes 05 Seconds West a distance of 54.80 feet;
thence South 02 Degrees 13 Minutes 45 Seconds West a distance of 100.76 feet;
thence South 02 Degrees 14 Minutes 50 Seconds East a distance of 100.43 feet;
thence South 13 Degrees 56 Minutes 45 Seconds East a distance of 94.07 feet;
thence South 00 Degrees 24 Minutes 35 Seconds East a distance of 219.37 feet;
thence South 59 Degrees 56 Minutes 30 Seconds West a distance of 43.30 feet;
thence South 88 Degrees 49 Minutes 15 Seconds West a distance of 39.20 feet;
thence North 79 Degrees 18 Minutes 55 Seconds West a distance of 124.79 feet;
thence South 78 Degrees 09 Minutes 00 Seconds West a distance of 95.50 feet;
thence South 78 Degrees 30 Minutes 30 Seconds West a distance of 90.70 feet;
thence South 55 Degrees 35 Minutes 45 Seconds West a distance of 136.65 feet;
thence South 41 Degrees 10 Minutes 50 Seconds West a distance of 49.90 feet;
thence South 27 Degrees 59 Minutes 55 Seconds West a distance of 46.80 feet;
thence South 26 Degrees 29 Minutes 40 Seconds West a distance of 57.85 feet;
thence South 07 Degrees 19 Minutes 25 Seconds West a distance of 47.44 feet;
thence South 29 Degrees 53 Minutes 55 Seconds West a distance of 28.55 feet;
thence South 72 Degrees 51 Minutes 10 Seconds West a distance of 27.20 feet;
thence North 76 Degrees 21 Minutes 15 Seconds West a distance of 40.25 feet;
thence South 89 Degrees 57 Minutes 55 Seconds West a distance of 66.10 feet;
thence North 79 Degrees 12 Minutes 30 Seconds West a distance of 83.10 feet;
thence South 57 Degrees 01 Minutes 55 Seconds West a distance of 70.00 feet;
thence South 44 Degrees 54 Minutes 50 Seconds West a distance of 127.63 feet to a point on the northerly line of Parcel 3 and southerly line of Lands of Johnson as shown on a Parcel Map recorded in Book 465 of Maps at page 41, Santa Clara County Records, said point bears South 88 Degrees 57 Minutes 00 Seconds East a distance of 207.25 feet from the northwesterly corner of said Parcel 3 and is the terminus of this portion of the description of the water pipeline.

Affects A.P.N. 544-35-018, L810 O.R. 1038

90 DEGREE ELBOW & G.V. (SEE DTL. RIGHT)

3" 150# FLANGED 90 DEGREE ELBOW & THRUST BLOCK

3" HDPE 150# FLANGE (BY PIPE MANUFACTURER)
3" HDPE
3" FLANGED G.V. (PER DTL. SHT. 11)

AS-BUILT NOTES:

1. COMPILED BY BINKLEY ASSOCIATES FROM WATER LINE EASEMENT SURVEY OF THE CROSS-COUNTRY PORTION OF THE PROJECT BY WESTFALL ENGINEERS, INC. AND MEASUREMENTS OF VISIBLE FACILITIES ON THE ROAD PORTION BY BINKLEY ASSOCIATES.
2. AS-BUILT STATIONING OF THE WATER LINE CENTER LINE REPRESENTS SLOPE DISTANCES ON THE ROAD PORTION, AND HORIZONTAL DISTANCES ON THE CROSS-COUNTRY PORTION.
3. WATER LINE ROUGHLY FOLLOWS THE CENTER LINE OF THE WATER LINE EASEMENT.
4. A TRACER WIRE IS INSTALLED WITH ALL NON-METALLIC PIPE FOR PRECISE LOCATION IN THE FIELD.


CROSS-COUNTRY (SEE AS-BUILT NOTES & TABLE A - THIS SHEET)

875 L.F. 3" SDR 13.8 HDPE PIPE

LEGEND

- FIRE HYDRANT (FH)
- ✕ GATE VALVE (GV)
- BLOW OFF (B/O)
- AIR VALVE (AV)
- WATER SERVICE (WS)
- STAGING AREA (AS STAKED IN THE FIELD)
- EXISTING TREE
- EXISTING PAVED ROAD
- - - EXISTING UNPAVED ROAD

AS BUILT DRAWING
DEC 06 1993
DATE

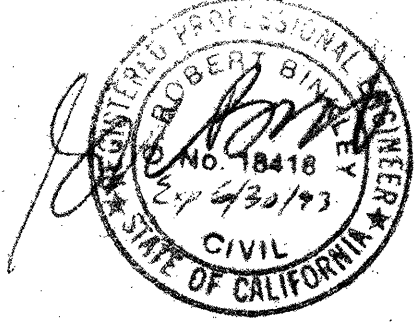

PROFILE: LINE "C"
SCALE: HORIZ. 1" = 50'
VERT. 1" = 20'

NO. 1245 - PLAN PROFILE PLATE A
"CLEARPRINT" PAPER CO.
MADE IN U.S.A.

3/18/92
ISSUED FOR BIDS
Addendum #1
PAGE 13-1
PIPE LENGTH
AS-BUILT
12/06/1993
M.J.

Binkley Associates

CONSULTING ENGINEERS

7246 SHARON DRIVE • SAN JOSE • CALIFORNIA 95129

BRUSH & OLD WELL MUTUAL WATER CO.

REMEDIAL WATER SYSTEM

WATER SUPPLY TRANSMISSION

PLAN PROFILE

PIPELINE "C" TANK TO STA. 25+00

DATE: 3/18/92

SCALE: AS SHOWN

DRAWN: M.J. & W.R.

JOB #: 22003

SHEET: 6

OF 12 SHEETS

PHASE II