

SANTA CLARA COUNTY

SOUTH COR. PCL. 2
PER P.M. 465 MAP 41
(SEE TABLE B, THIS SHT.)

AS-BUILT NOTES:

1. COMPILED BY BINKLEY ASSOCIATES FROM WATER LINE EASEMENT SURVEY OF THE CROSS-COUNTRY PORTION OF THE PROJECT BY WESTFALL ENGINEERS, INC. AND MEASUREMENTS OF VISIBLE FACILITIES ON THE ROAD PORTION BY BINKLEY ASSOCIATES.
2. AS-BUILT STATIONING OF THE WATER LINE CENTER LINE REPRESENTS SLOPE DISTANCES ON THE ROAD PORTION, AND HORIZONTAL DISTANCES ON THE CROSS-COUNTRY PORTION.
3. WATER LINE ROUGHLY FOLLOWS THE CENTER LINE OF THE WATER LINE EASEMENT.
4. A TRACER WIRE IS INSTALLED WITH ALL NON-METALLIC PIPE FOR PRECISE LOCATION IN THE FIELD.

TABLE B
PART 4 OF "EXHIBIT A - DESCRIPTION OF THE WATER PIPE LINE FOR BRUSH AND OLD WELL MUTUAL WATER COMPANY". (CENTER LINE OF WATER LINE EASEMENT)

Part 4:
Cross country portion of the pipeline over Lands of Clark is more particularly described as follows:

Beginning at a point on the northerly line of Parcel 3 and southerly line of Lands of Johnson as shown on a Parcel Map recorded in Book 465 of Maps at page 41, Santa Clara County Records, said point bears South 88 Degrees 57 Minutes 00 Seconds East a distance of 207.25 feet from the northwesterly corner of said Parcel 3;
thence South 44 Degrees 54 Minutes 50 Seconds West a distance of 35.00 feet;
thence South 13 Degrees 14 Minutes 35 Seconds East a distance of 131.03 feet;
thence South 38 Degrees 47 Minutes 55 Seconds East a distance of 70.54 feet;
thence South 14 Degrees 47 Minutes 00 Seconds East a distance of 71.60 feet;
thence South 02 Degrees 22 Minutes 30 Seconds West a distance of 61.30 feet;
thence South 24 Degrees 17 Minutes 10 Seconds West a distance of 80.80 feet;
thence South 50 Degrees 07 Minutes 30 Seconds East a distance of 93.93 feet;
thence South 19 Degrees 49 Minutes 15 Seconds East a distance of 68.45 feet;
thence South 22 Degrees 53 Minutes 10 Seconds East a distance of 92.60 feet;
thence South 46 Degrees 23 Minutes 15 Seconds East a distance of 54.30 feet;
thence South 17 Degrees 19 Minutes 40 Seconds East a distance of 56.04 feet to a point which is the most southerly corner of Parcel 2 as shown on a Parcel Map recorded in Book 465 of Maps at page 41, Santa Clara County Records, said point being the terminus of this description.

Affects following parcels of land in the Santa Clara County, California:

A.P.N. 544-49-19, 3105 O.R. 142
A.P.N. 544-49-18, 3105 O.R. 142
A.P.N. 544-49-17, 3105 O.R. 142




AS BUILT DRAWING

DATE DEC 06 1993 BY [Signature]

SANTA CRUZ COUNTY PORTION OF WATER SUPPLY SYSTEM FOR BRUSH & OLD WELL MUTUAL

SHEET INDEX (FOR SANTA CRUZ COUNTY PORTION ONLY)

SHEET NO.	DESCRIPTION
7	PLAN / PROFILE: PIPELINE "C" STA. 25+00 TO STA. 40+00
8	PLAN / PROFILE: PIPELINE "C" STA. 40+00 TO STA. 55+00
9	PLAN / PROFILE: PIPELINE "C" STA. 55+00 TO RES. #5
12	WATER SUPPLY SYSTEM DETAILS

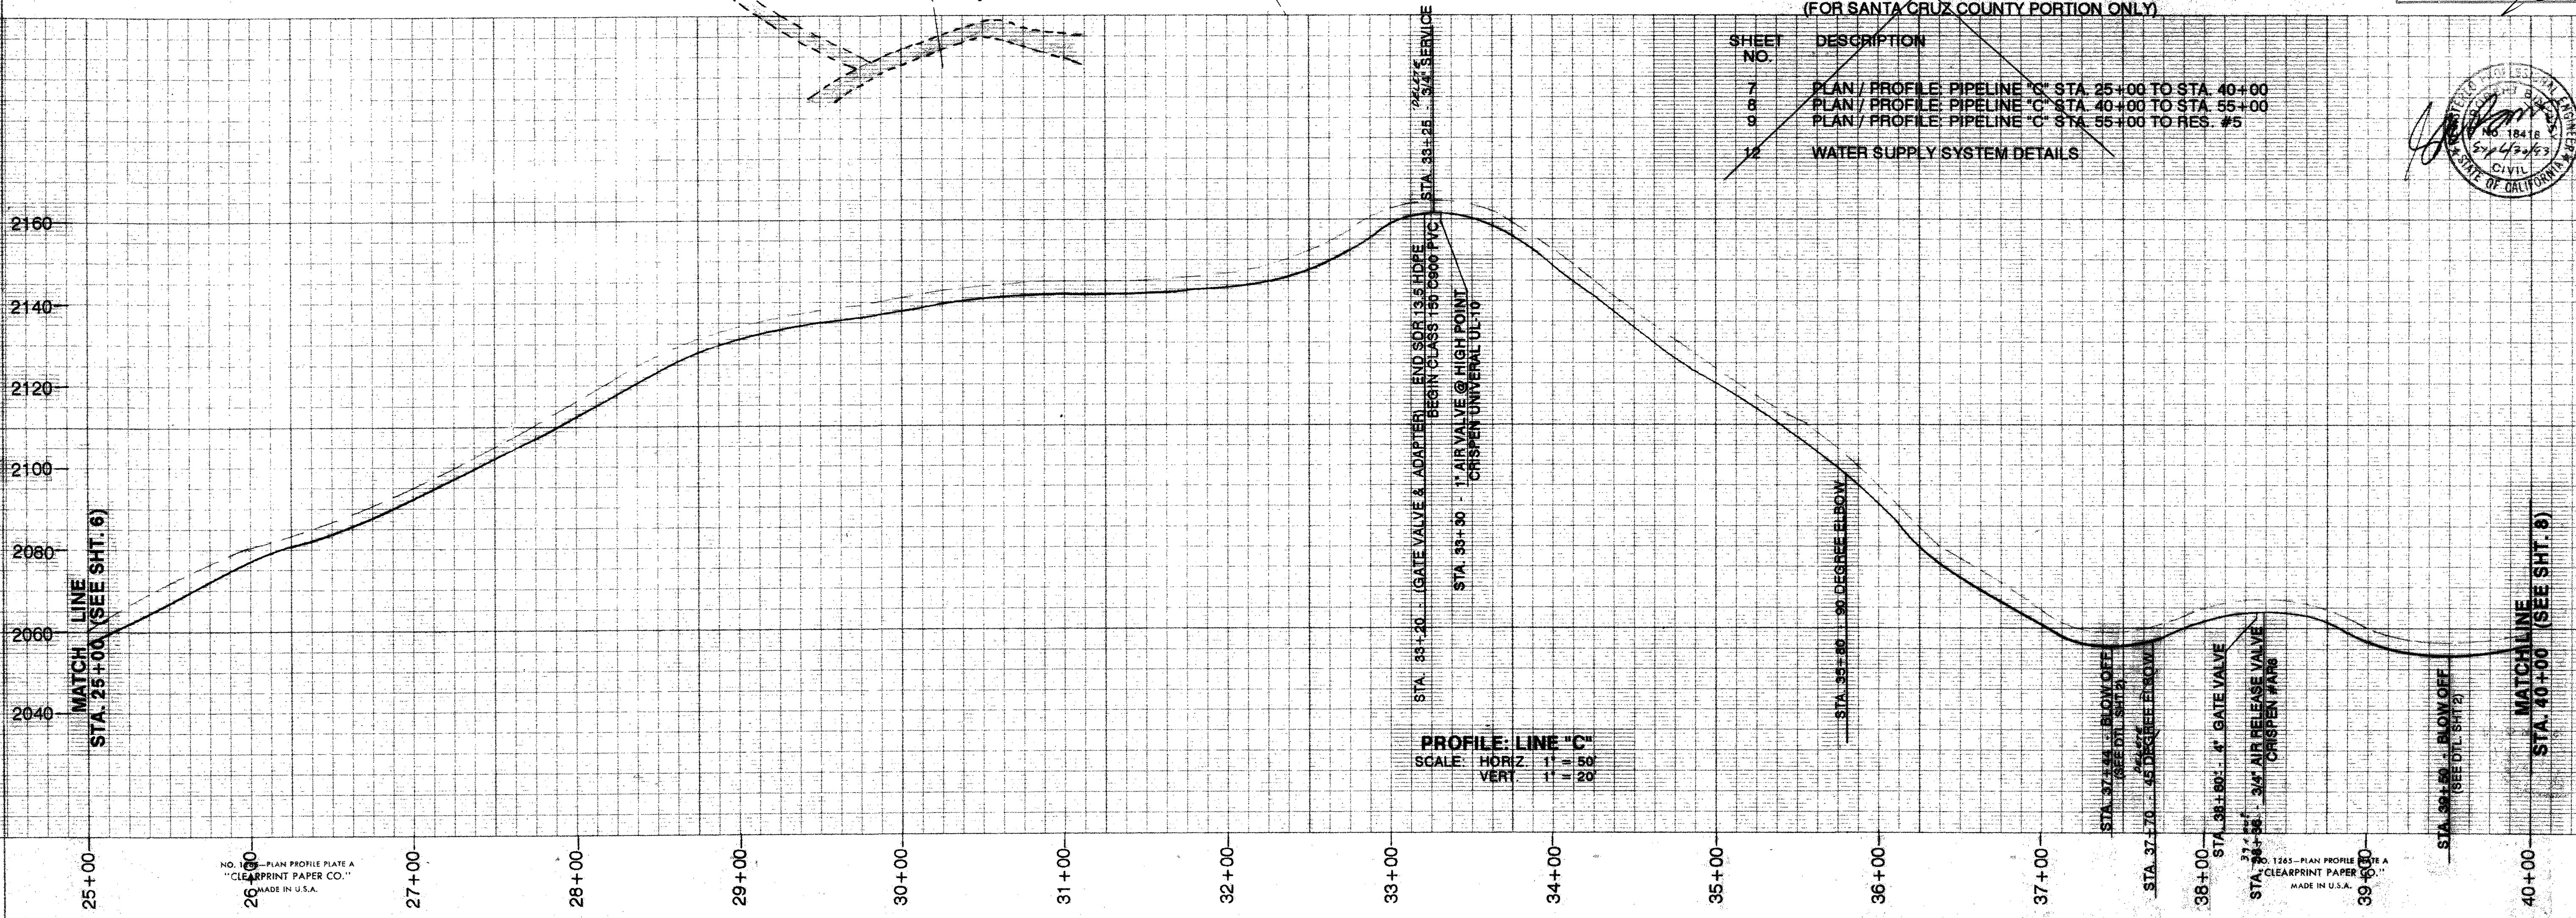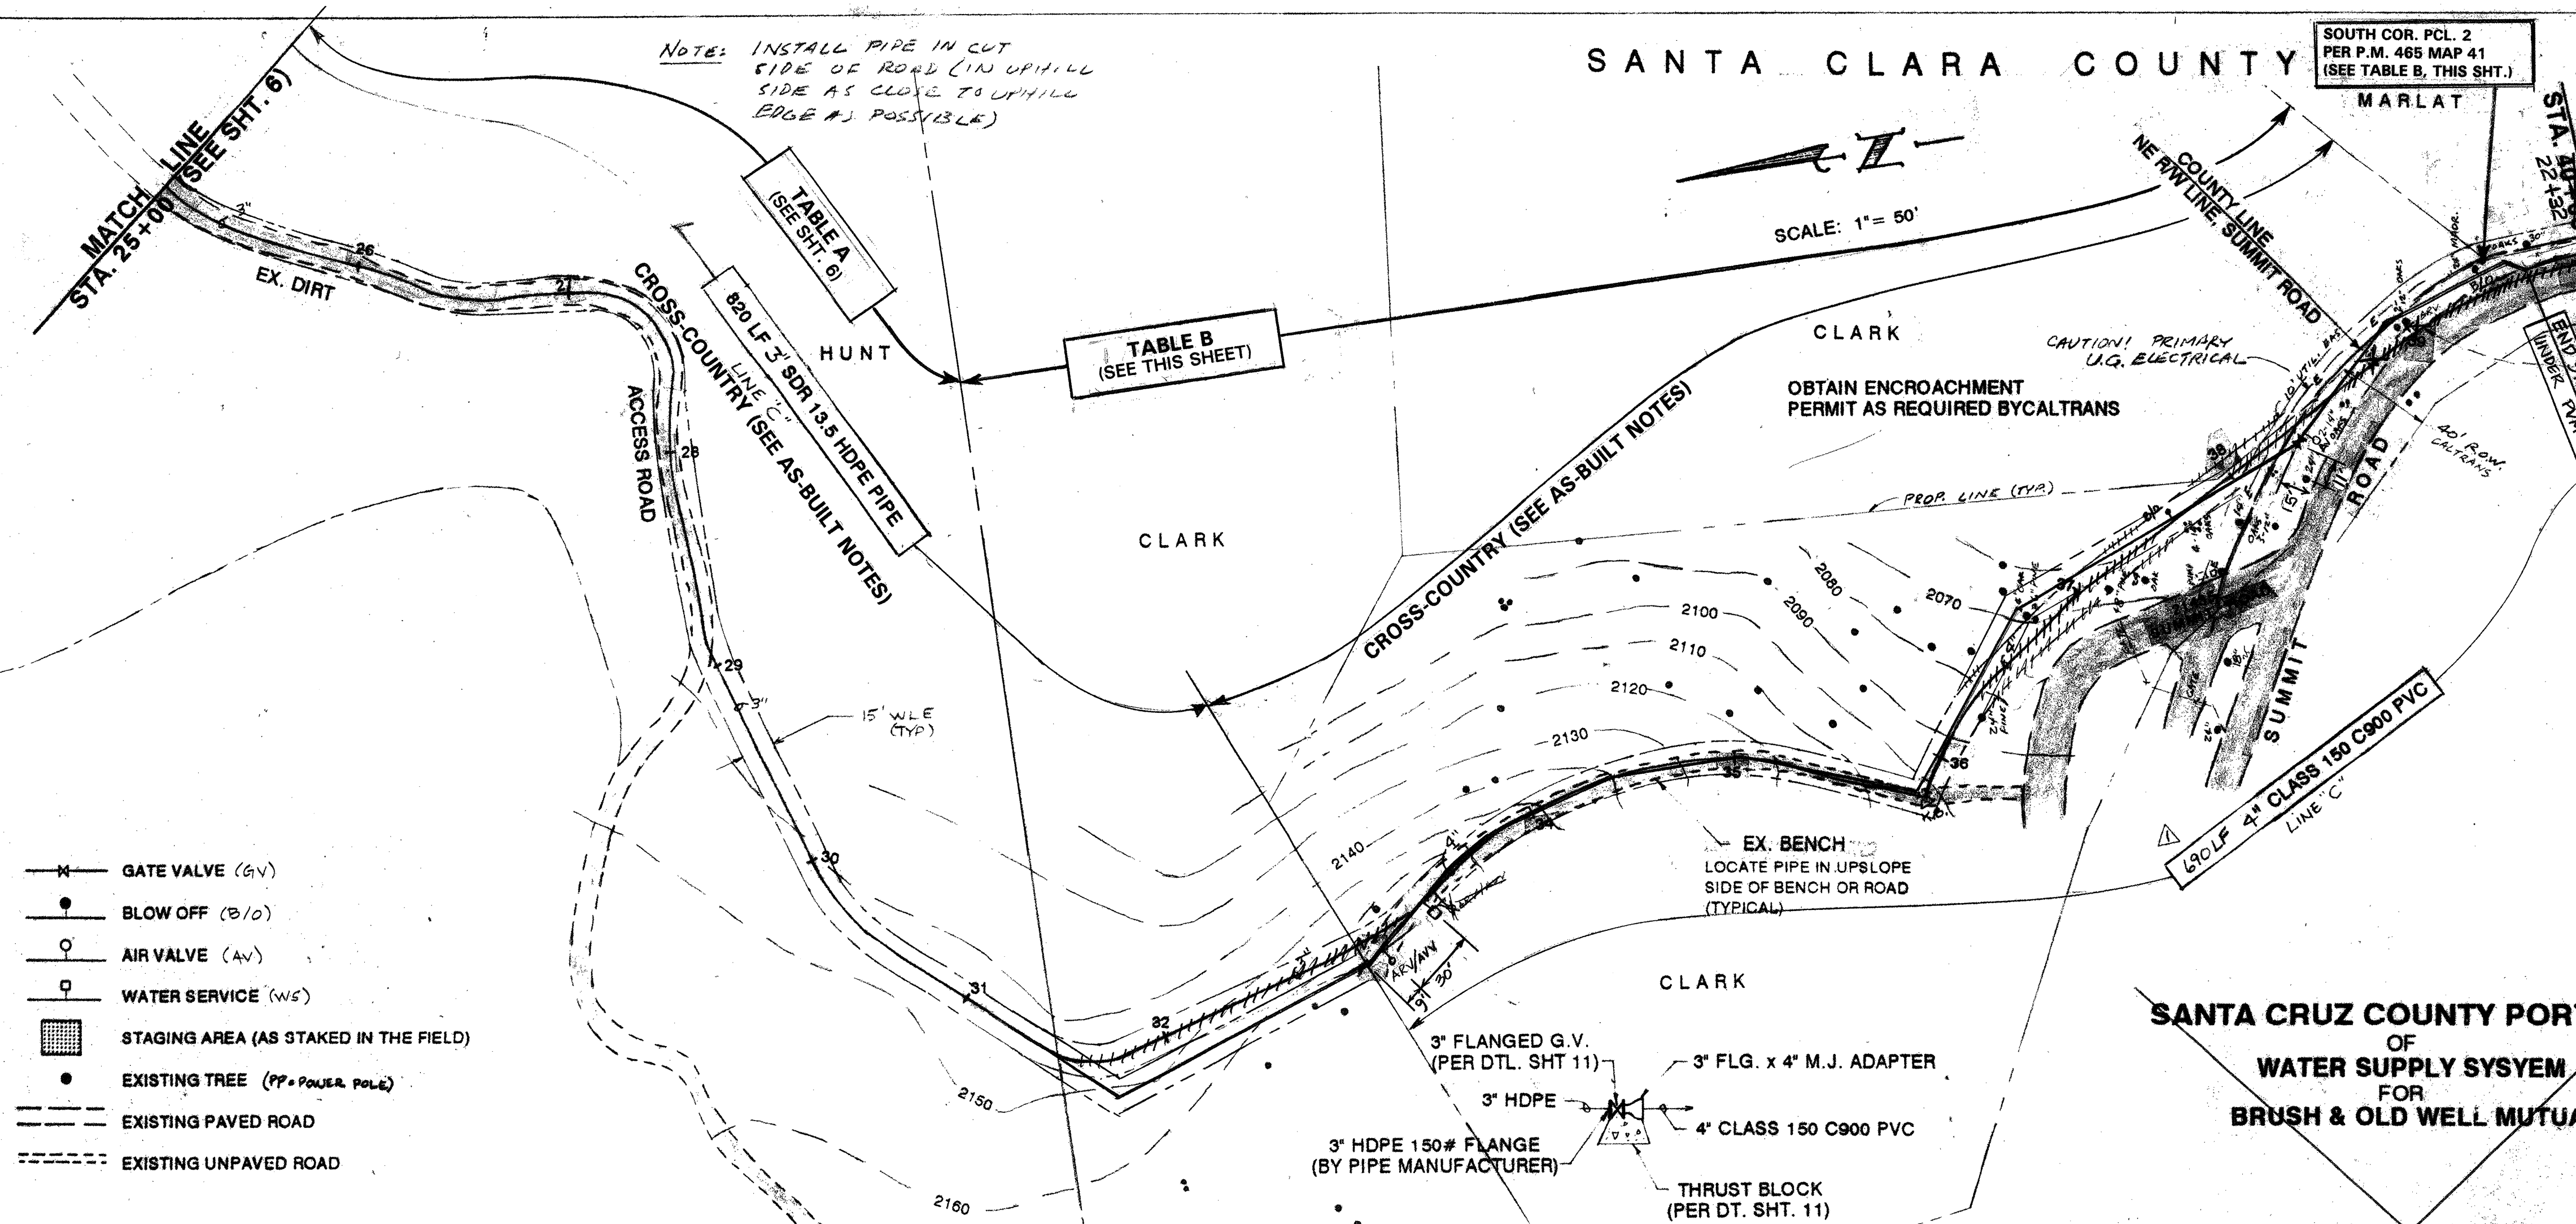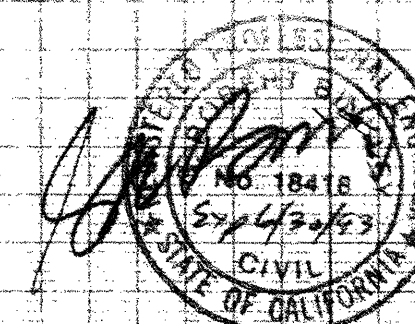

Binkley Associates
CONSULTING ENGINEERS
7246 SHARON DRIVE • SAN JOSE • CALIFORNIA 95129

WATER SUPPLY TRANSMISSION
PLAN/PROFILE
PIPELINE "C" STA. 25+00 TO STA. 40+00

BRUSH & OLD WELL MUTUAL WATER CO.
REMEDIAL WATER SYSTEM

DATE: 3/16/92
SCALE: AS SHOWN
DRAWN: M.J. & W.R.
JOB #: 22003
SHEET: 7
OF 12 SHEETS