
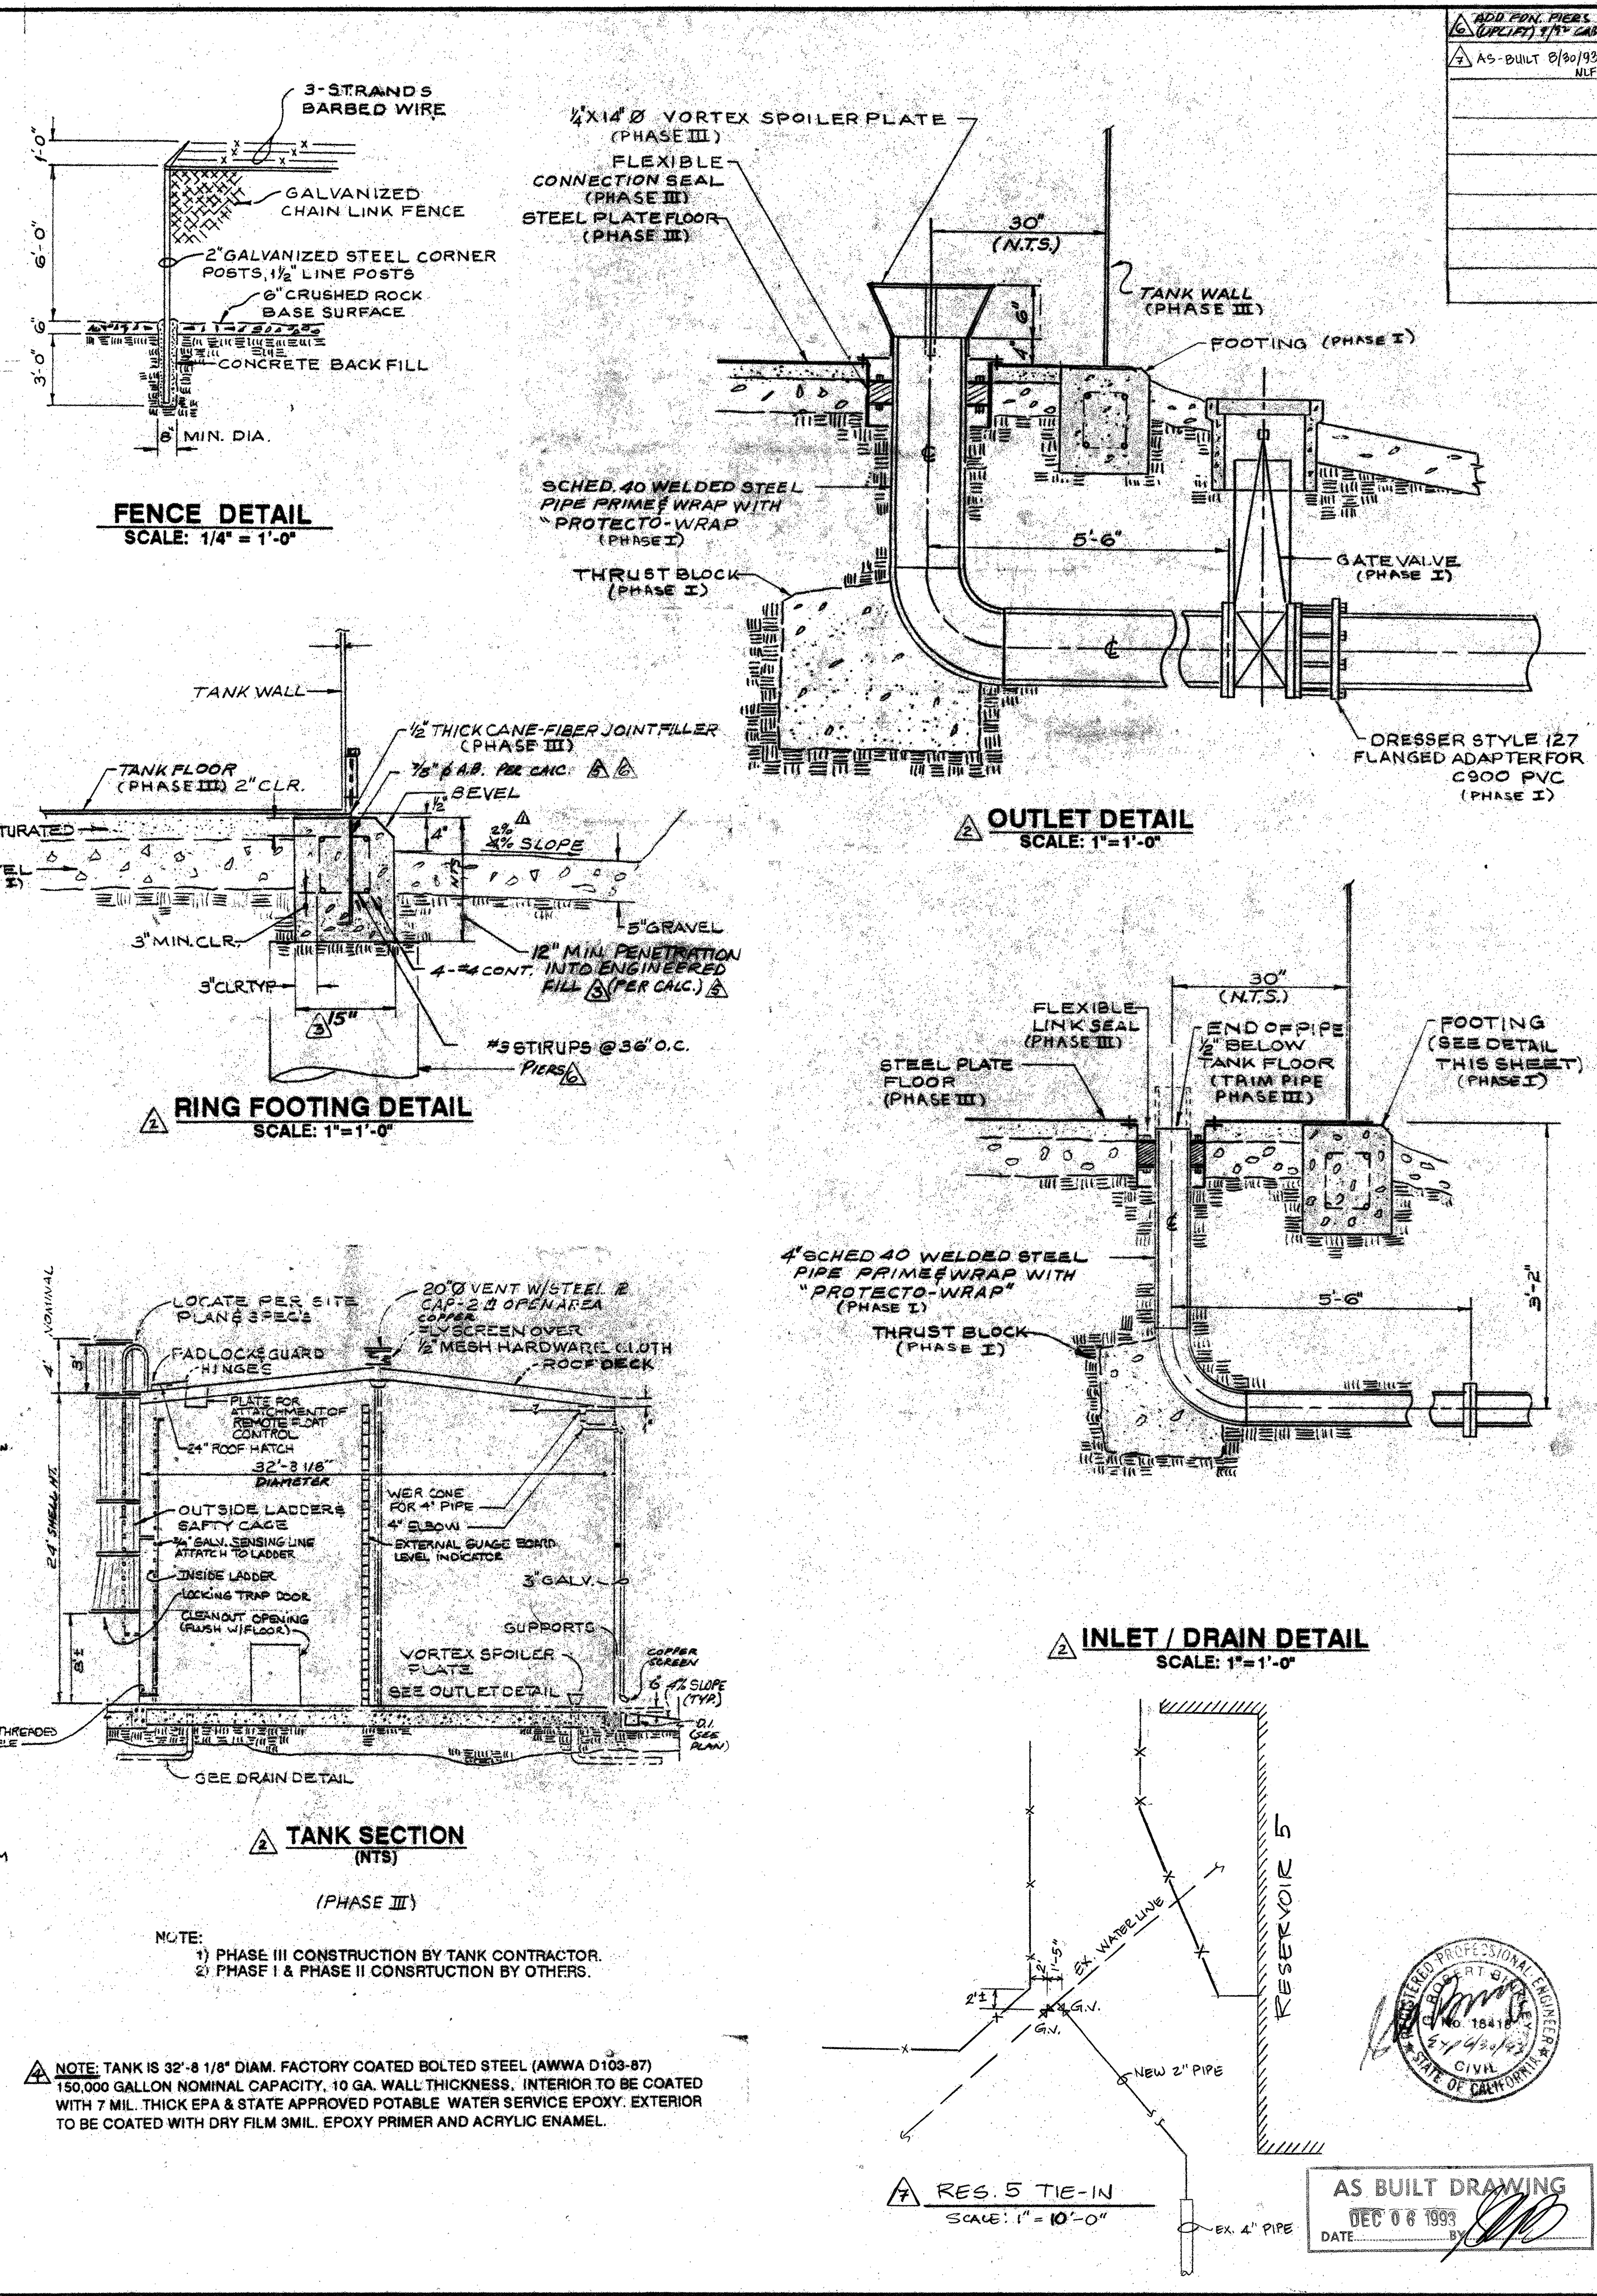


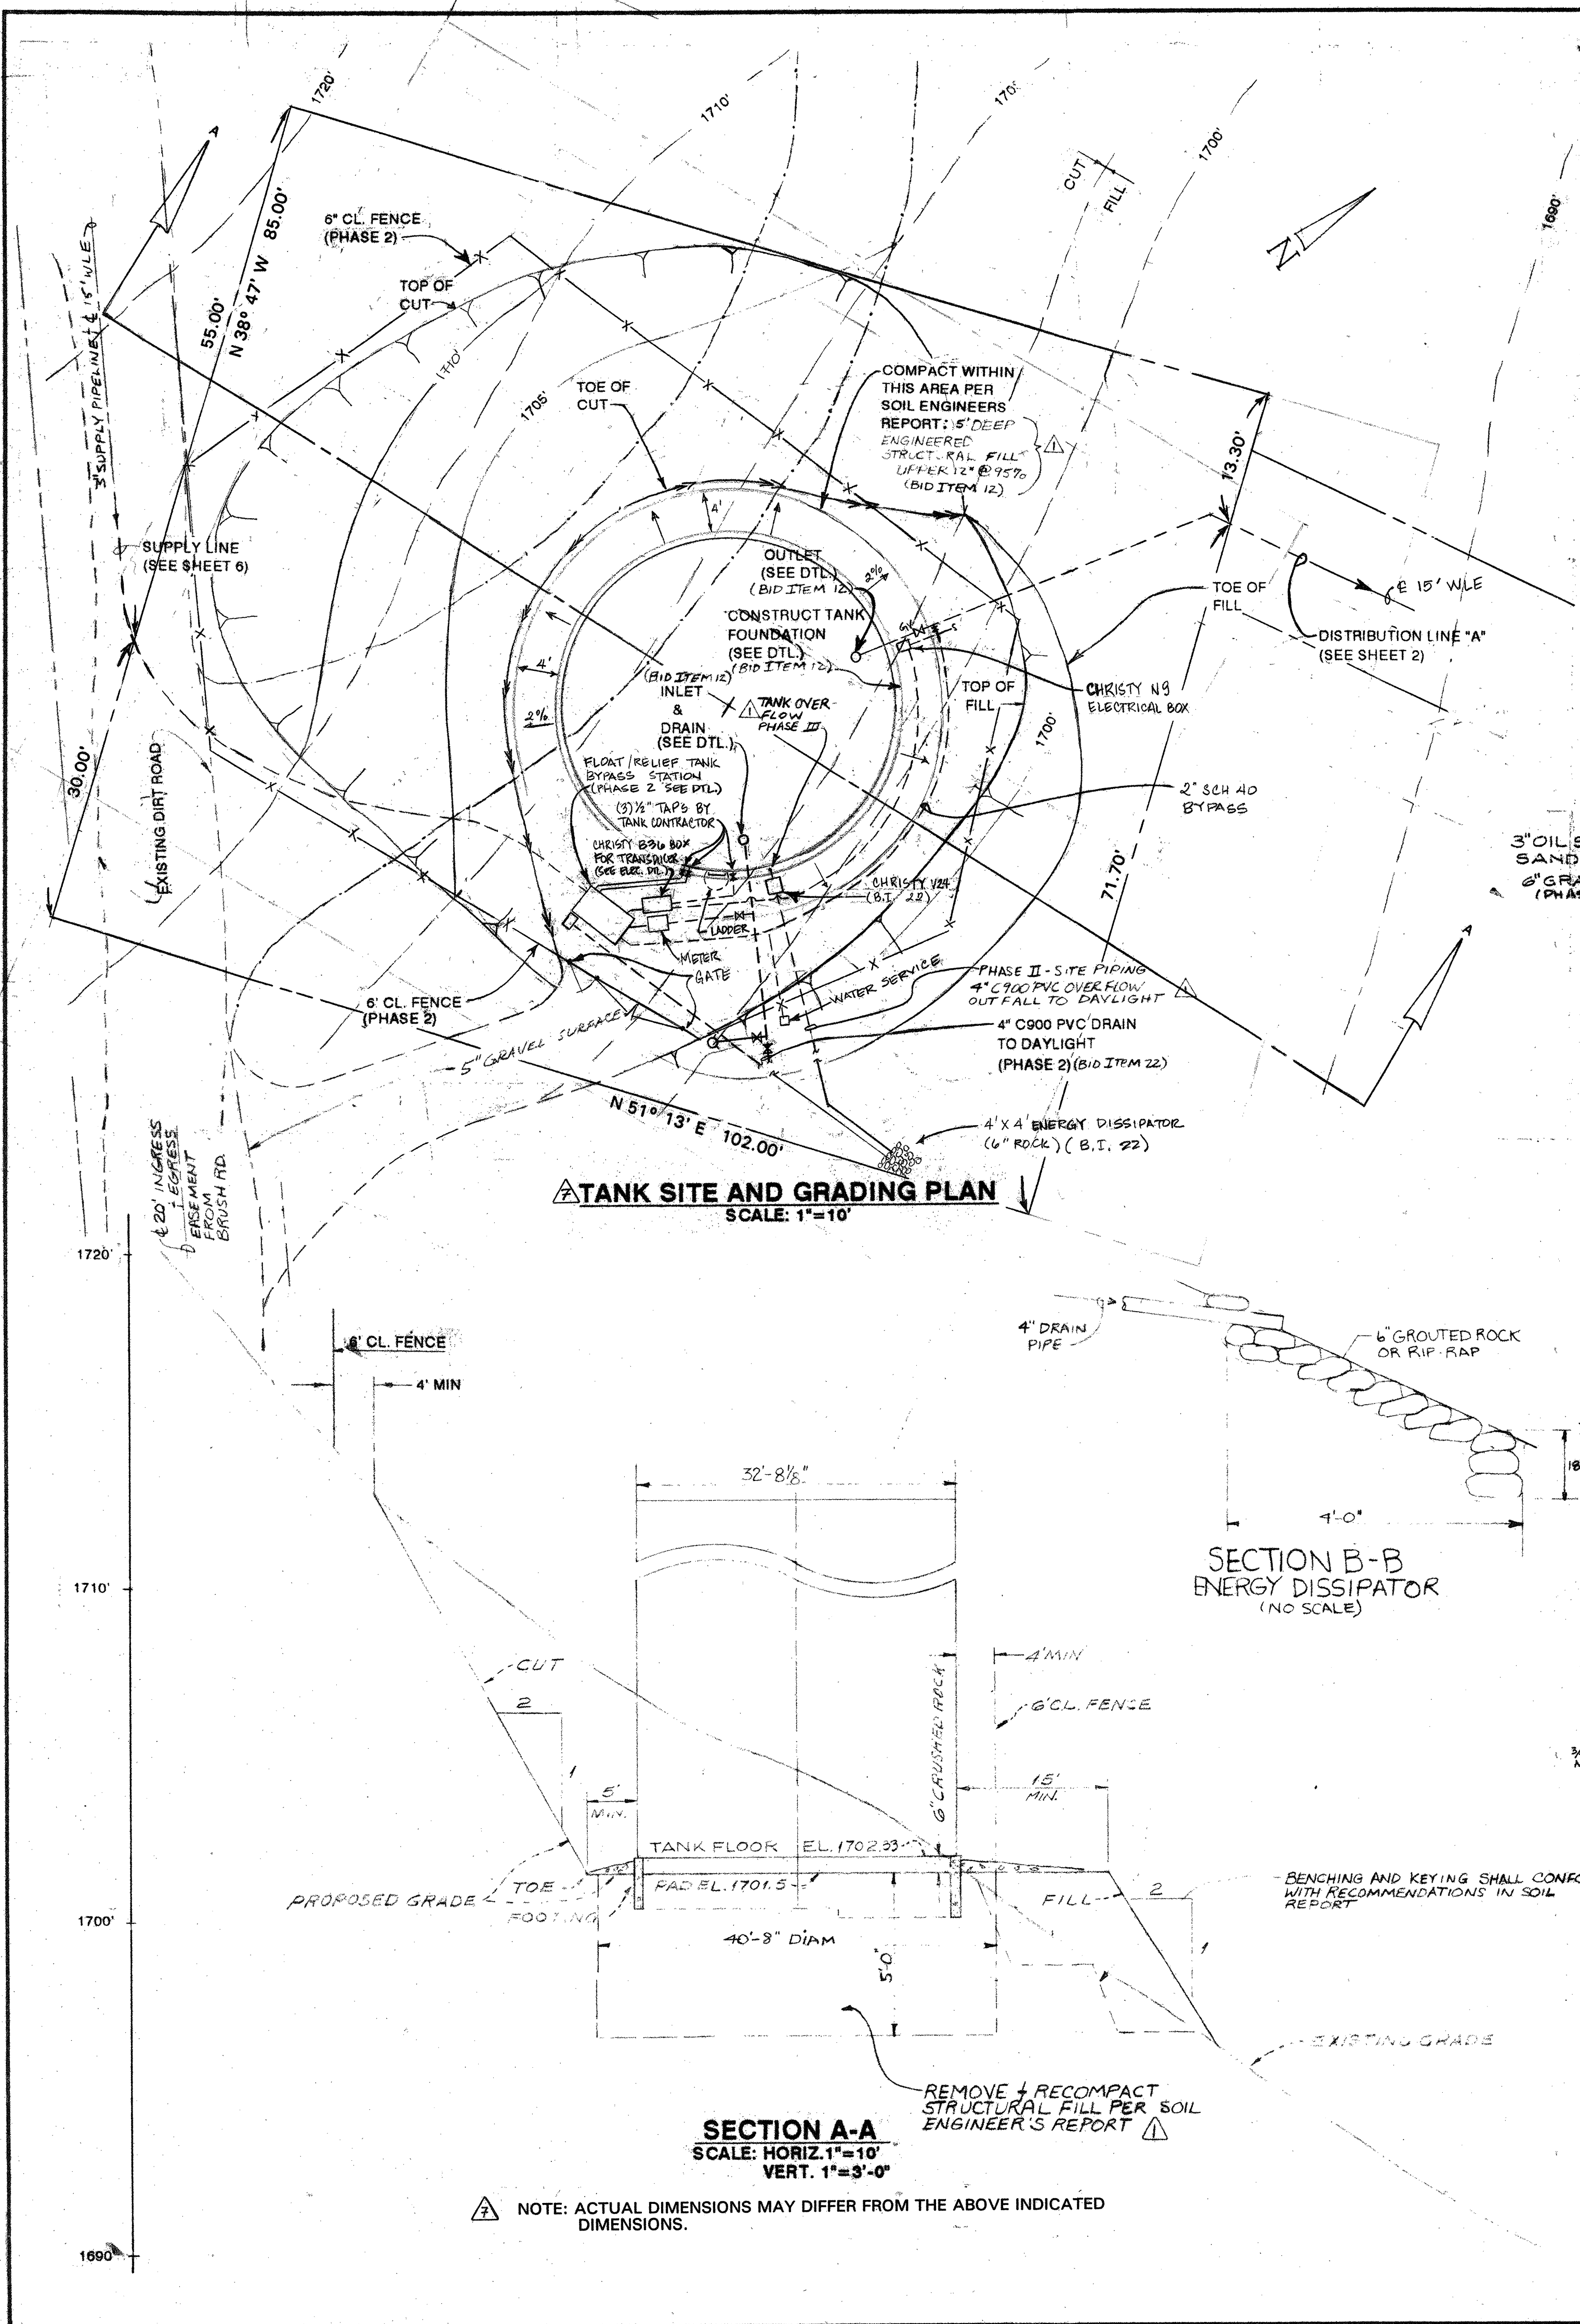

|                                    |
|------------------------------------|
| ADD FON. PIERS<br>(UPCIRT) 1/17/93 |
| 7 AS-BUILT 8/20/93<br>MLF          |
|                                    |
|                                    |
**Binkley Associates**  
CONSULTING ENGINEERS  
7246 SHARON DRIVE • SAN JOSE, CALIFORNIA 95129

WATER DISTRIBUTION STORAGE TANK

BRUSH & OLD WELL MUTUAL WATER CO.  
REMEDIAL WATER SYSTEM

DATE: 11/05/91  
SCALE: AS SHOWN  
DRAWN: R.C.  
JOB: 22002  
SHEET: 10  
OF 12 SHEETS